


KEY WEST AND STOCK ISLAND FIBER LAYOUT

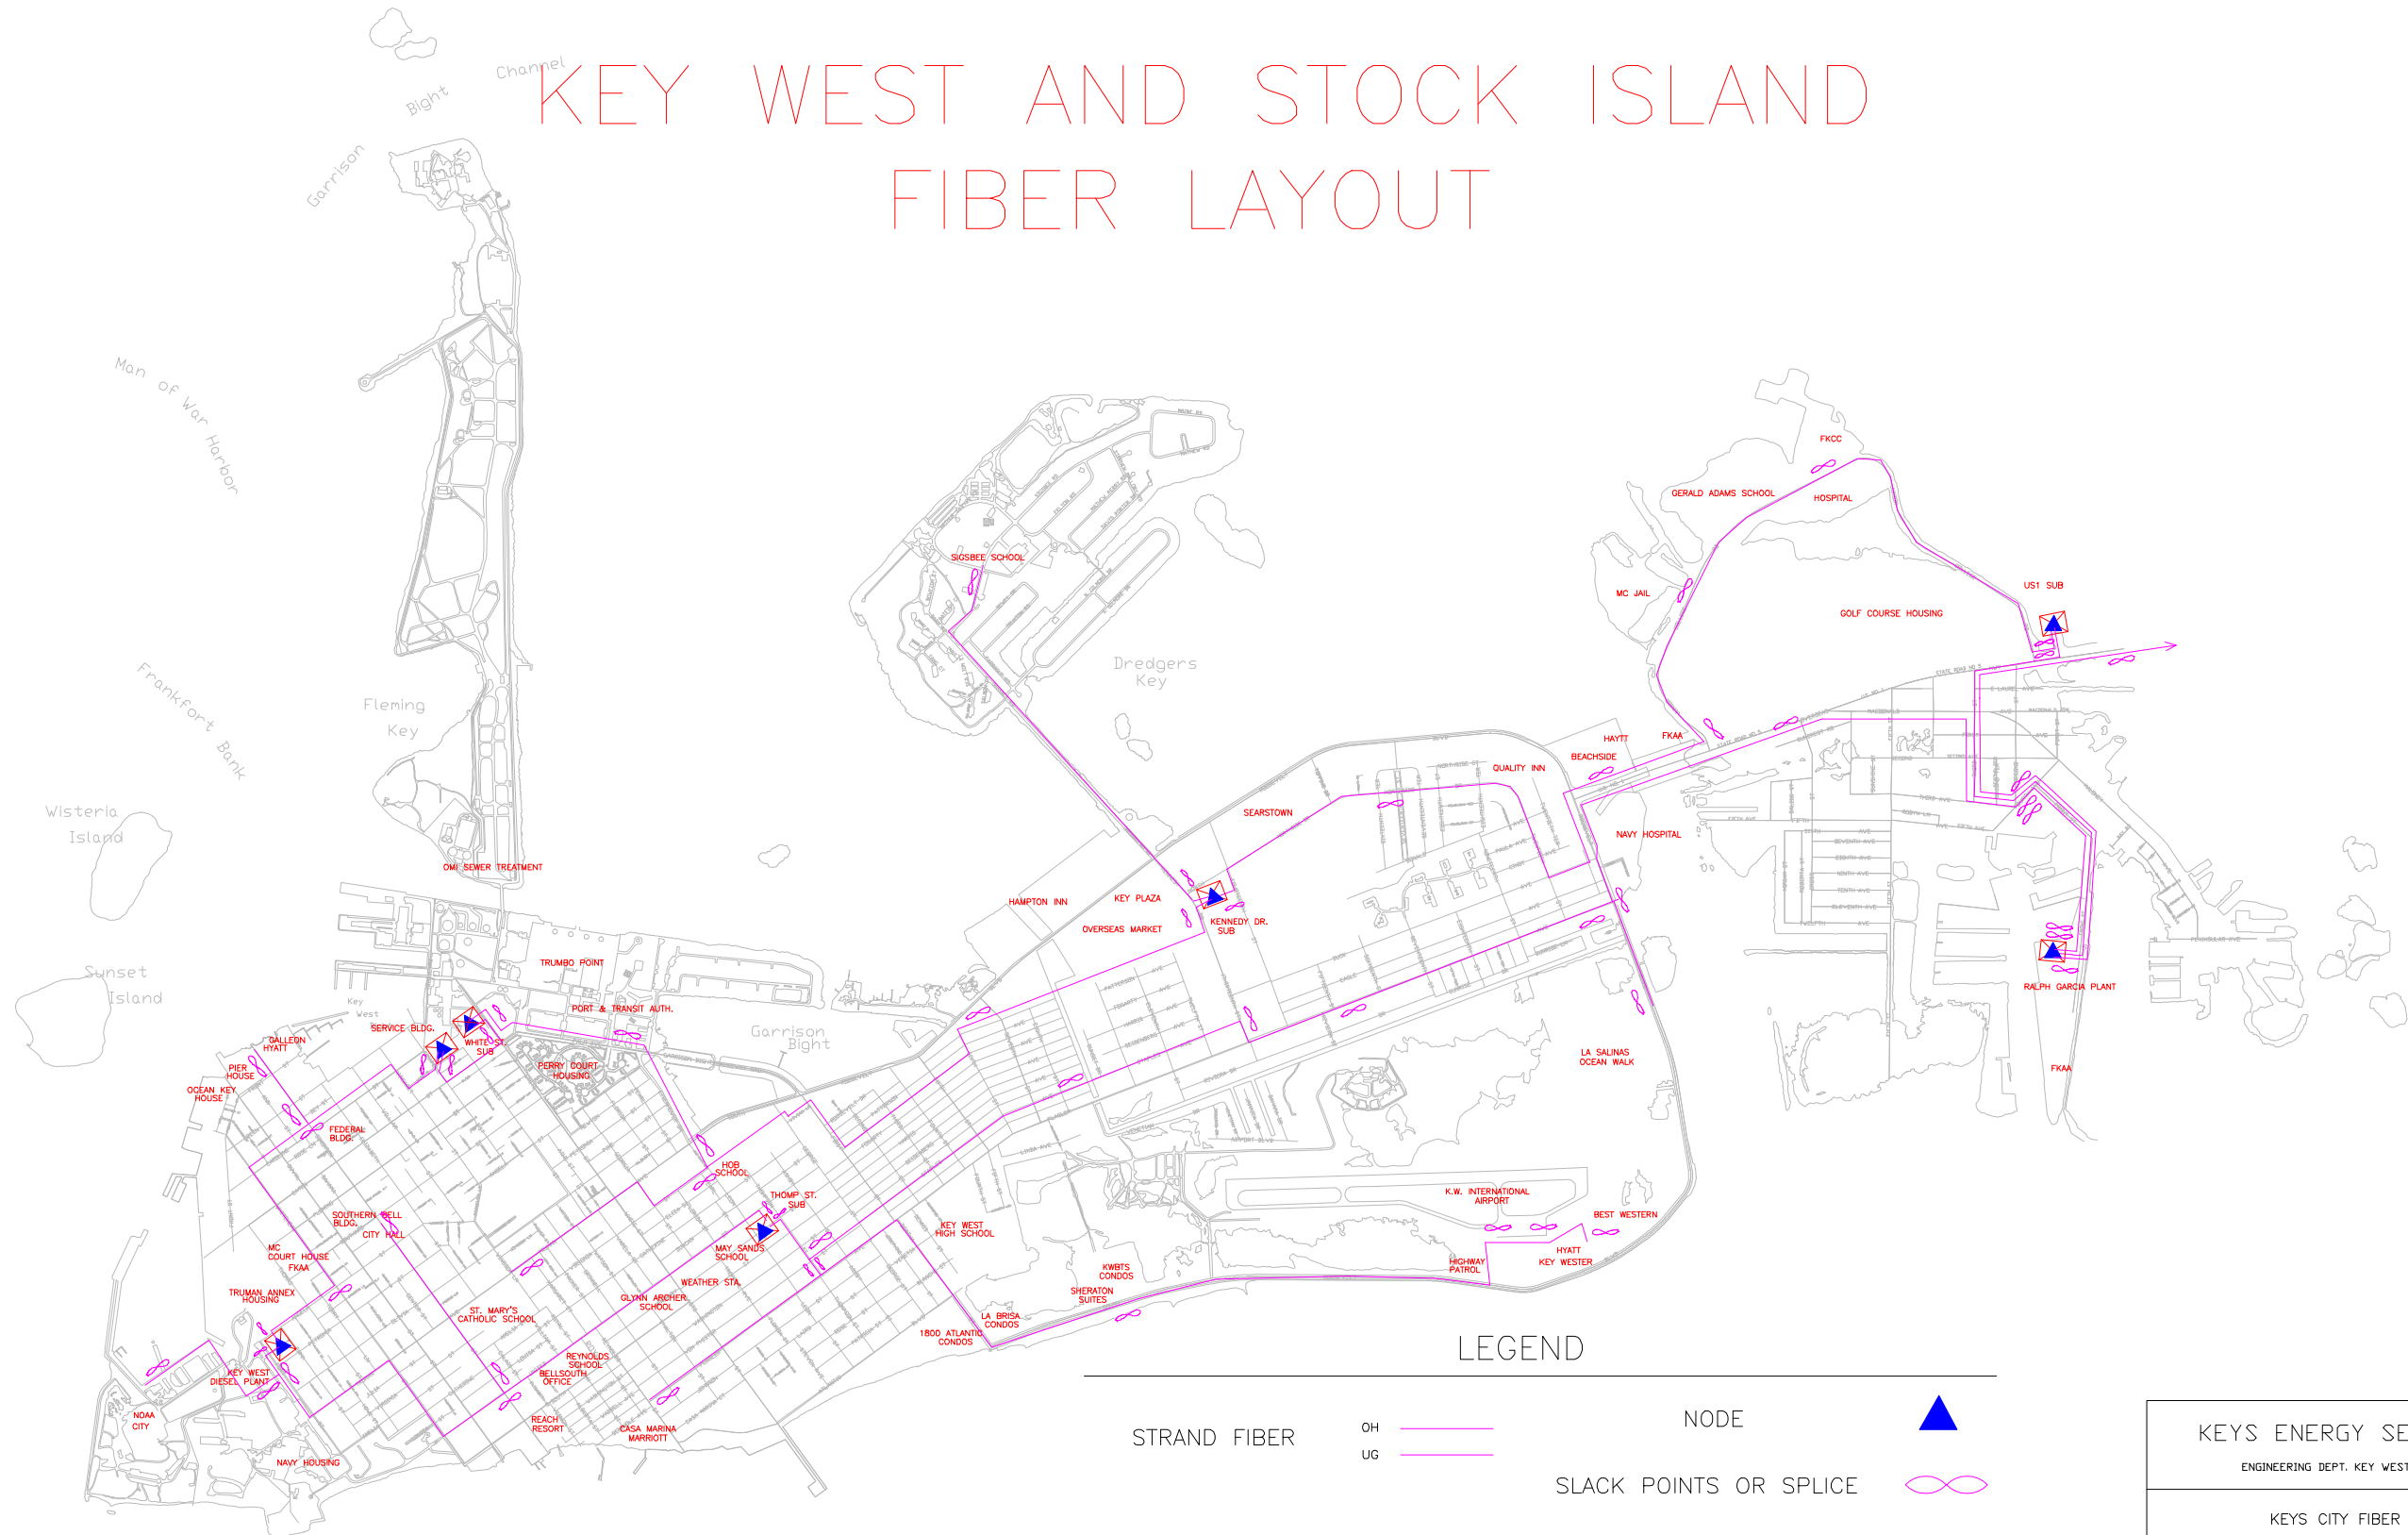

LEGEND

STRAND FIBER

OH 
UG 

NODE



SLACK POINTS OR SPLICE



PATCH PANEL



KEYS ENERGY SERVICES

ENGINEERING DEPT. KEY WEST FL.

KEYS CITY FIBER LAYOUT

DESIGNED BY: DALE FINIGAN

APPROVED BY: DALE FINIGAN

DRAWN BY: T. BETHEL

SCALE: = 1" = .2 MILES

DATE: 1-18-07

SHT. 1 OF 2 AS-BUILT