


KEYS FIBER LAYOUT

STOCK ISLAND TO MARATHON

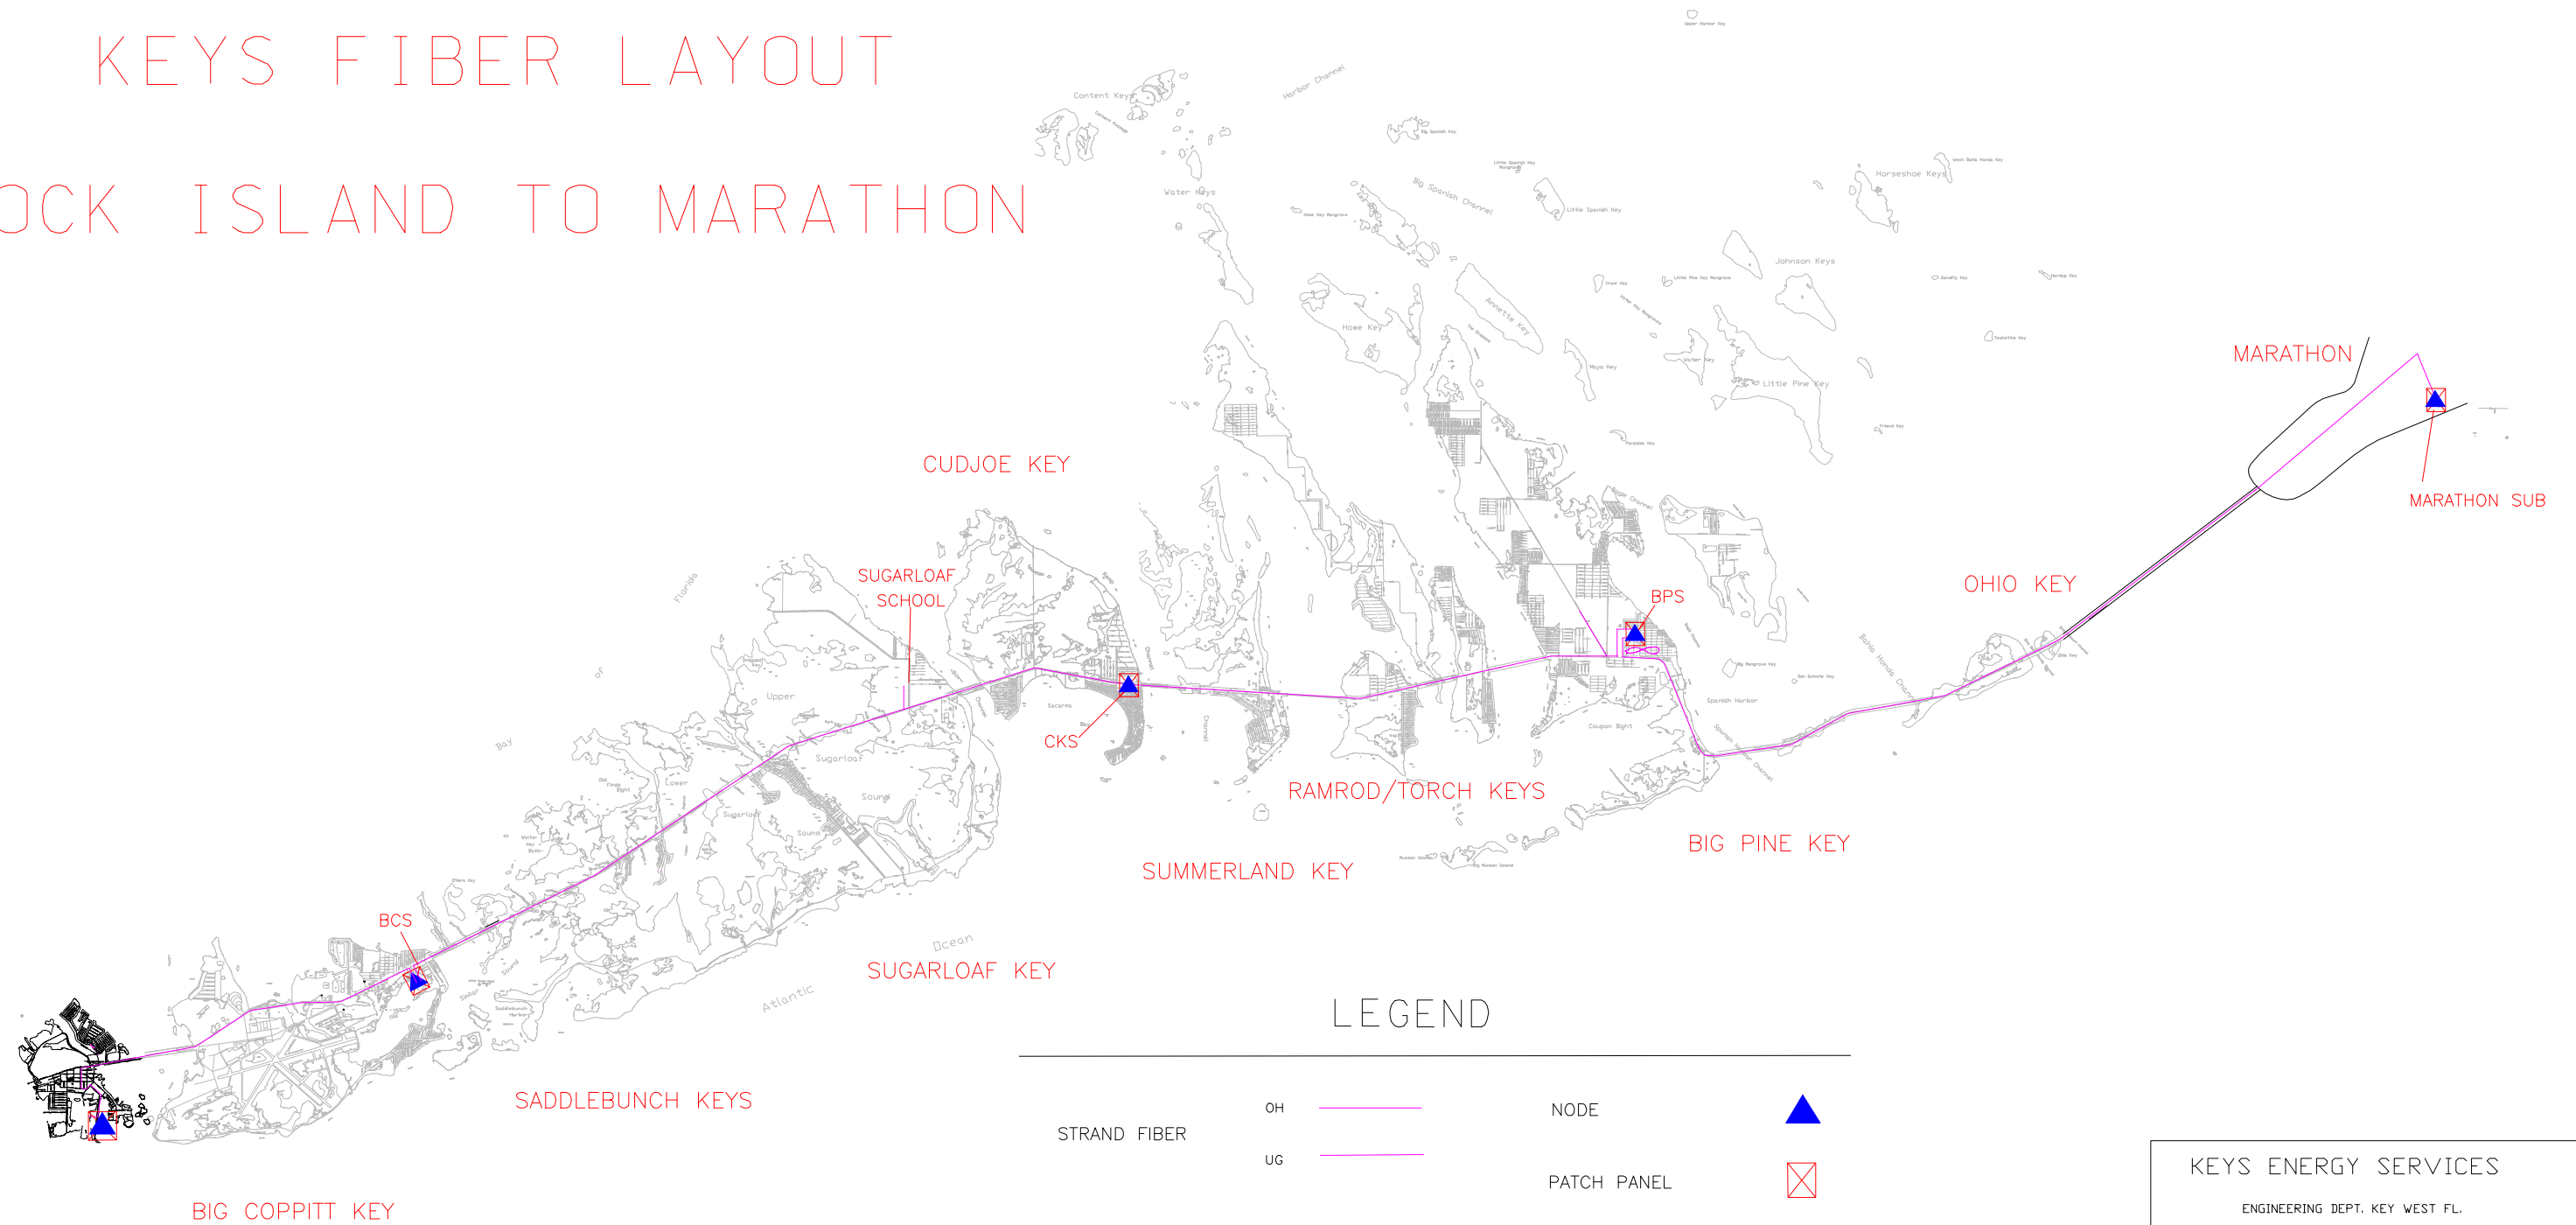

LEGEND

STRAND FIBER	OH		NODE	
	UG		PATCH PANEL	

KEYS ENERGY SERVICES	
ENGINEERING DEPT. KEY WEST FL.	
KEYS FIBER LAYOUT STOCK ISLAND TO MARATHON	
DESIGN BY: DALE FINGIN	APPROVED BY: DALE FINGIN
DRAWN BY: T. BETHEL	SCALE: APPROX 1" = 1.2 MILES
DATE: 1-18-07	SHT. 2 OF 2 AS-BUILT